4507

IMPROVEMENT SURVEY PLAT

SCALE: 1"=30'
JOB NO: 1302'
DRAWN BY: P.H.
DATE DRAWN: 2-21-97

Carroll & Lange Inc
Professional Engineers & Land Surveyors
165 South Union Blvd., Suite 156
Lakewood, Colorado 80228
(303) 980-0200

● STEEL PIN
+ CROSSES
○ METAL DISCS

℄= PROPERTY LINE
BOW= BACK OF WALK
℄ = FLOW LINE

PROP. TGB=
AS-BUILT TGB=

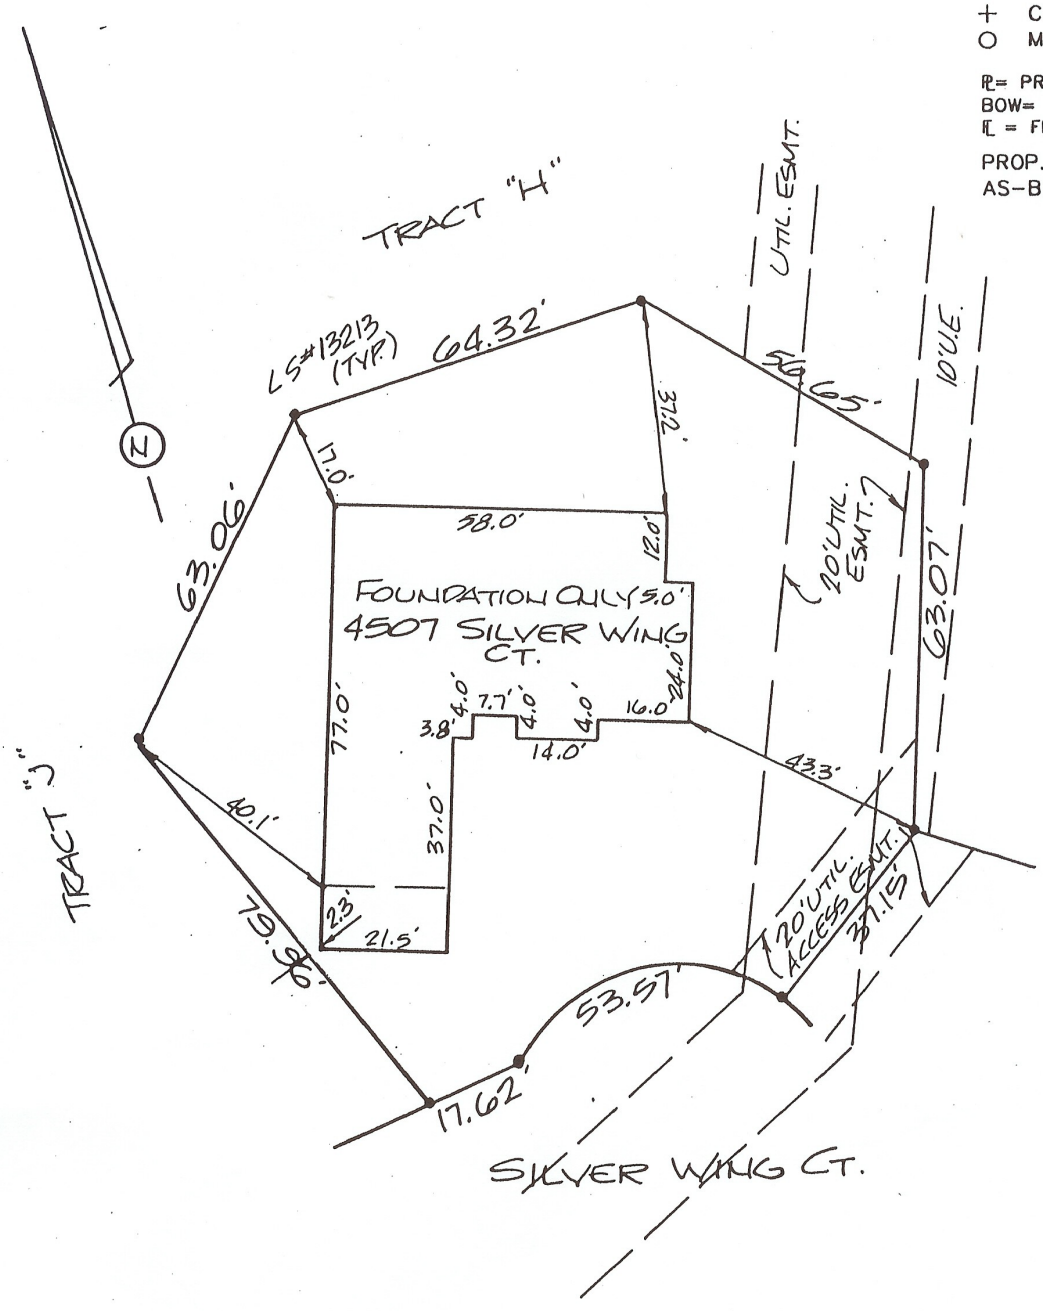

THIS CERTIFIES THAT THE ABOVE IS A CORRECT PLAT OF A SURVEY MADE UNDER MY SUPERVISION THIS 18TH DAY OF FEB., 1997, OF THE PROPERTY DESCRIBED AS:

LOT 4507,
CASTLE PINES VILLAGE FLG.# 12-A,
COUNTY OF DOUGLAS,
STATE OF COLORADO