IMPROVEMENT SURVEY PLAT

SCALE: 1"=30'
JOB NO: 1302
DRAWN BY: PH.
DATE DRAWN: 9-17-97

Carroll & Lange Inc
Professional Engineers & Land Surveyors
165 South Union Blvd., Suite 156
Lakewood, Colorado 80228
(303) 980-0200

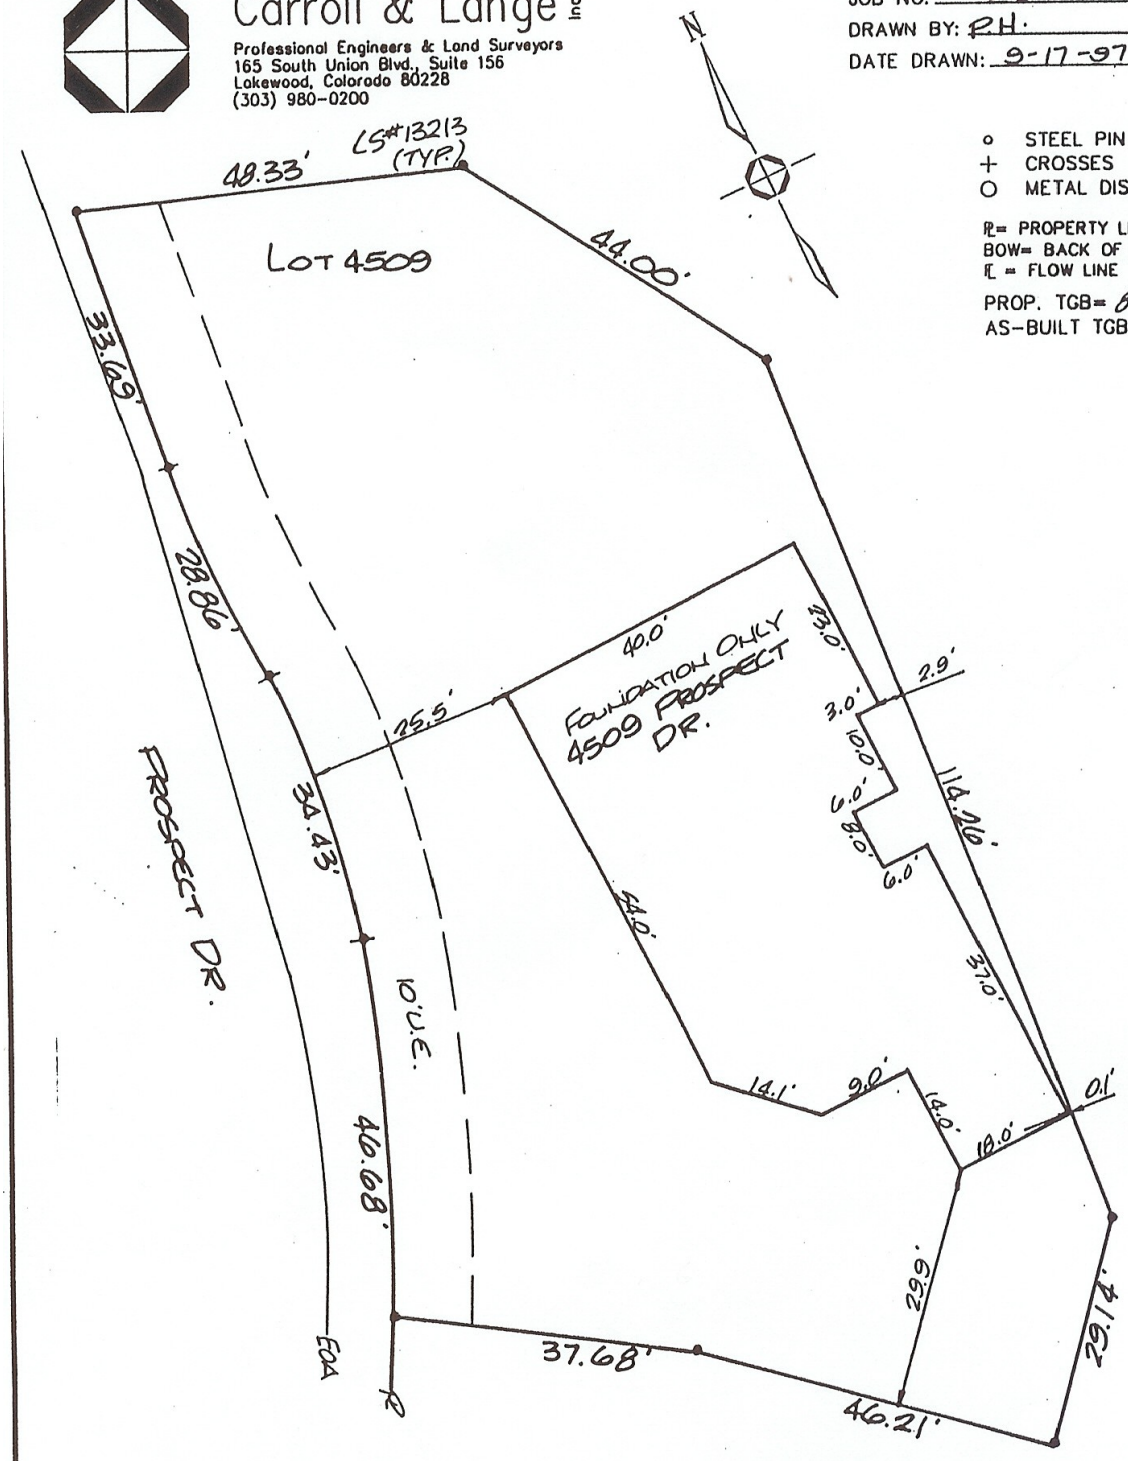

o STEEL PIN
+ CROSSES
O METAL DISCS

℄= PROPERTY LINE
BOW= BACK OF WALK
℄ = FLOW LINE

PROP. TGB= 87.5
AS-BUILT TGB=87.5

THIS CERTIFIES THAT THE ABOVE IS A CORRECT PLAT OF A SURVEY MADE UNDER MY SUPERVISION THIS 15TH DAY OF SEPT., 1997, OF THE PROPERTY DESCRIBED AS:

LOT 4509
CASTLE PINES VILLAGE FLG.#12-A.
COUNTY OF DOUGLAS,
STATE OF COLORADO

AND THAT THE LOCATION AND DIMENSIONS OF ALL BUILDING IMPROVEMENTS, EASEMENTS OR RIGHTS-OF-WAY IN EVIDENCE OR KNOWN TO ME AND ENCROACHMENTS BY OR ON THE PREMISES ARE ACCURATELY SHOWN.

KENNETH L. SHORT
PROFESSIONAL LAND SURVEYOR

BY: _____
DATE: 9/17/97
RECERTIFIED BY FINAL LAND SURVEY DATE: _____

THIS SURVEY REPRESENTS THE AS-MEASURED LOCATION OF THE FOUNDATION FORMS AS THEY EXISTED ON THE REFERENCED DATE.

NOTICE: ACCORDING TO COLORADO LAW YOU MUST COMMENCE ANY LEGAL ACTION BASED UPON ANY DEFECT IN THIS SURVEY WITHIN THREE YEARS AFTER YOU FIRST DISCOVERED SUCH DEFECT. IN NO EVENT MAY ANY ACTION BASED UPON ANY DEFECT IN THIS SURVEY BE COMMENCED MORE THAN TEN YEARS FROM THE DATE OF THE CERTIFICATION SHOWN HEREON.